



Rev	Amendments	By	Chkd	Date
A	As built issue.	BH	DJS	24/07/06

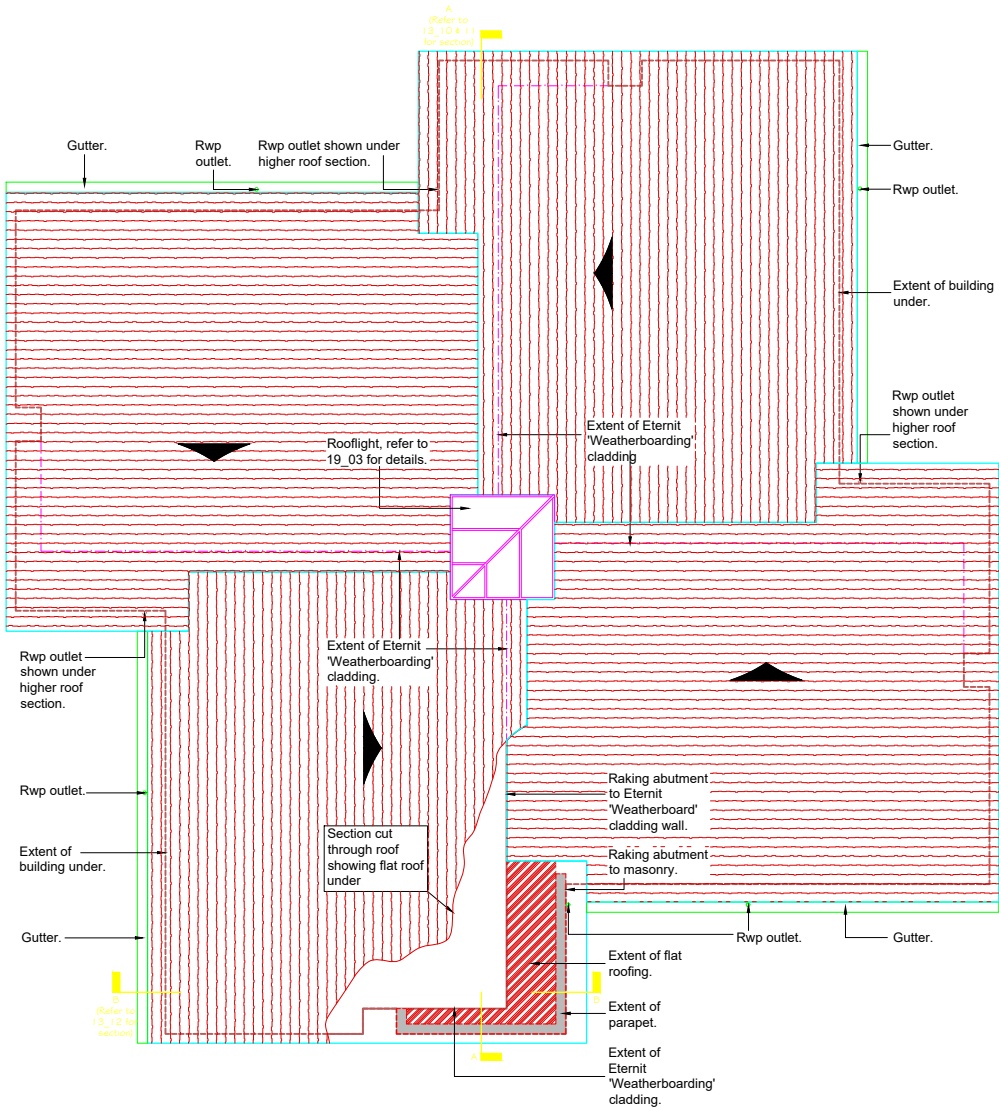

BLOCK A ROOF PLAN
BLOCK B ROOF PLAN (HANDED)

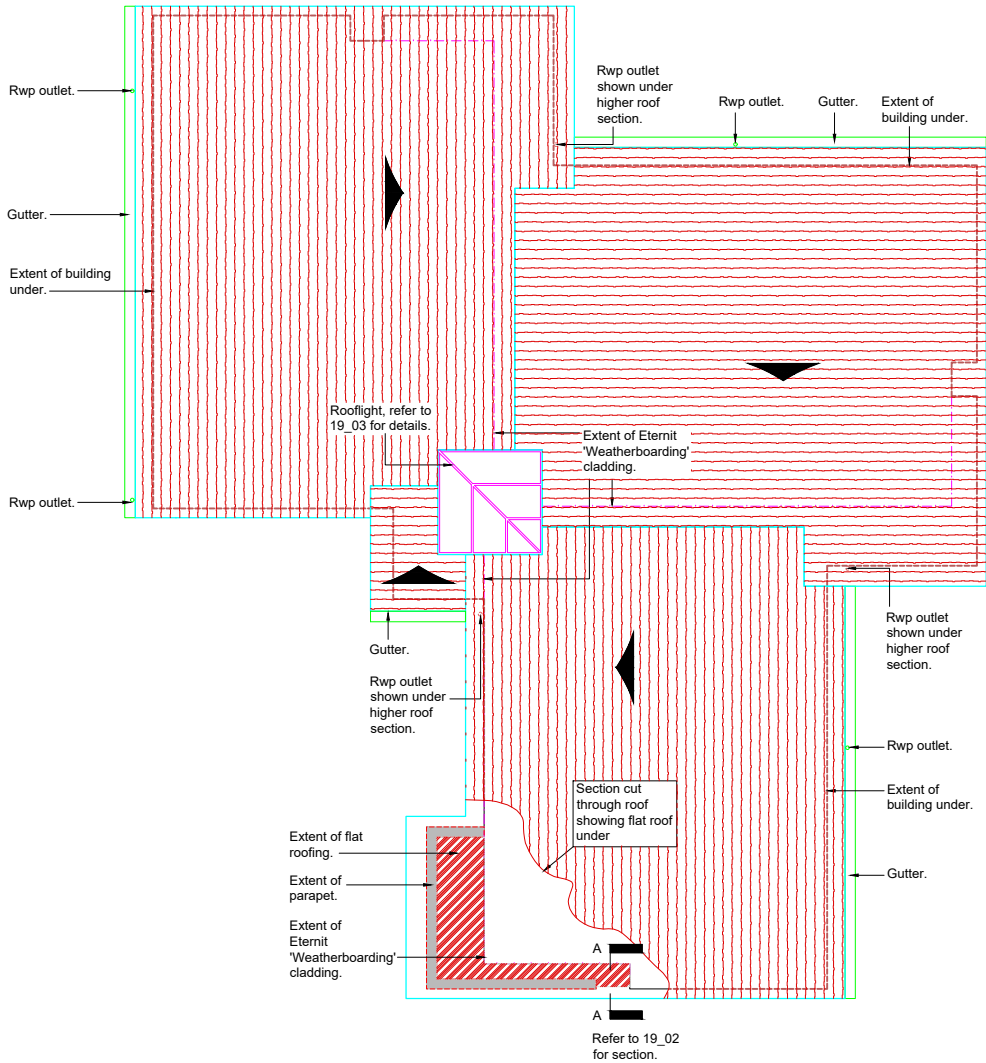

BLOCK C ROOF PLAN



HNW Architects, 11 West Pallant, Chichester, West Sussex, PO19 1TB
Tel: 01243 533300 Fax: 01243 533311 E-mail: hnw@hnw.co.uk www.hnw.co.uk

Project
**STUDENT RESIDENTIAL
ACCOMMODATION, U.C.C.
BISHOP OTTER CAMPUS**

Drawing Title
ROOF PLANS

Drawing Status AS BUILT			
Scale	Drawn By	Date	
1:100	BH	JAN. 2005	
Checked By	Date		
DJS	JAN. 2005		
Project No.	Drawing No.	Revision	
03021	19_01	A	