


Rev	Amendments	By	Chkd	Date
A	Counter battens amended to 1200mm centres. Notes amended.	BH	DJS	08/07/05
B	Curtaining walling detail amended. 3 course feature set back to 10mm.	BH	DJS	15/07/05
C	As built issue.	BH	DJS	24/07/06



THIS DRAWING IS TO BE READ INCONJUNCTION WITH THE ARCHITECTS GENERAL ARRANGEMENT PLANS AND ALL RELEVANT STRUCTURAL ENGINEERS DRAWINGS AND DETAILS.

APPROVED DOCUMENT PART E:-
WHERE FLOOR SLABS ARE BUILT INTO CAVITY WALLS AND ACROSS BEDROOM TO CORRIDOR WALLS, FILL IN ENDS OF HOLLOW CORE TO A DEPTH OF 150mm USING C30 CONCRETE.
WHERE FLOOR SLABS ARE BUILT INTO SEPARATING WALLS (215mm THICK) FILL AS ABOVE BUT TO A DEPTH OF 250mm.

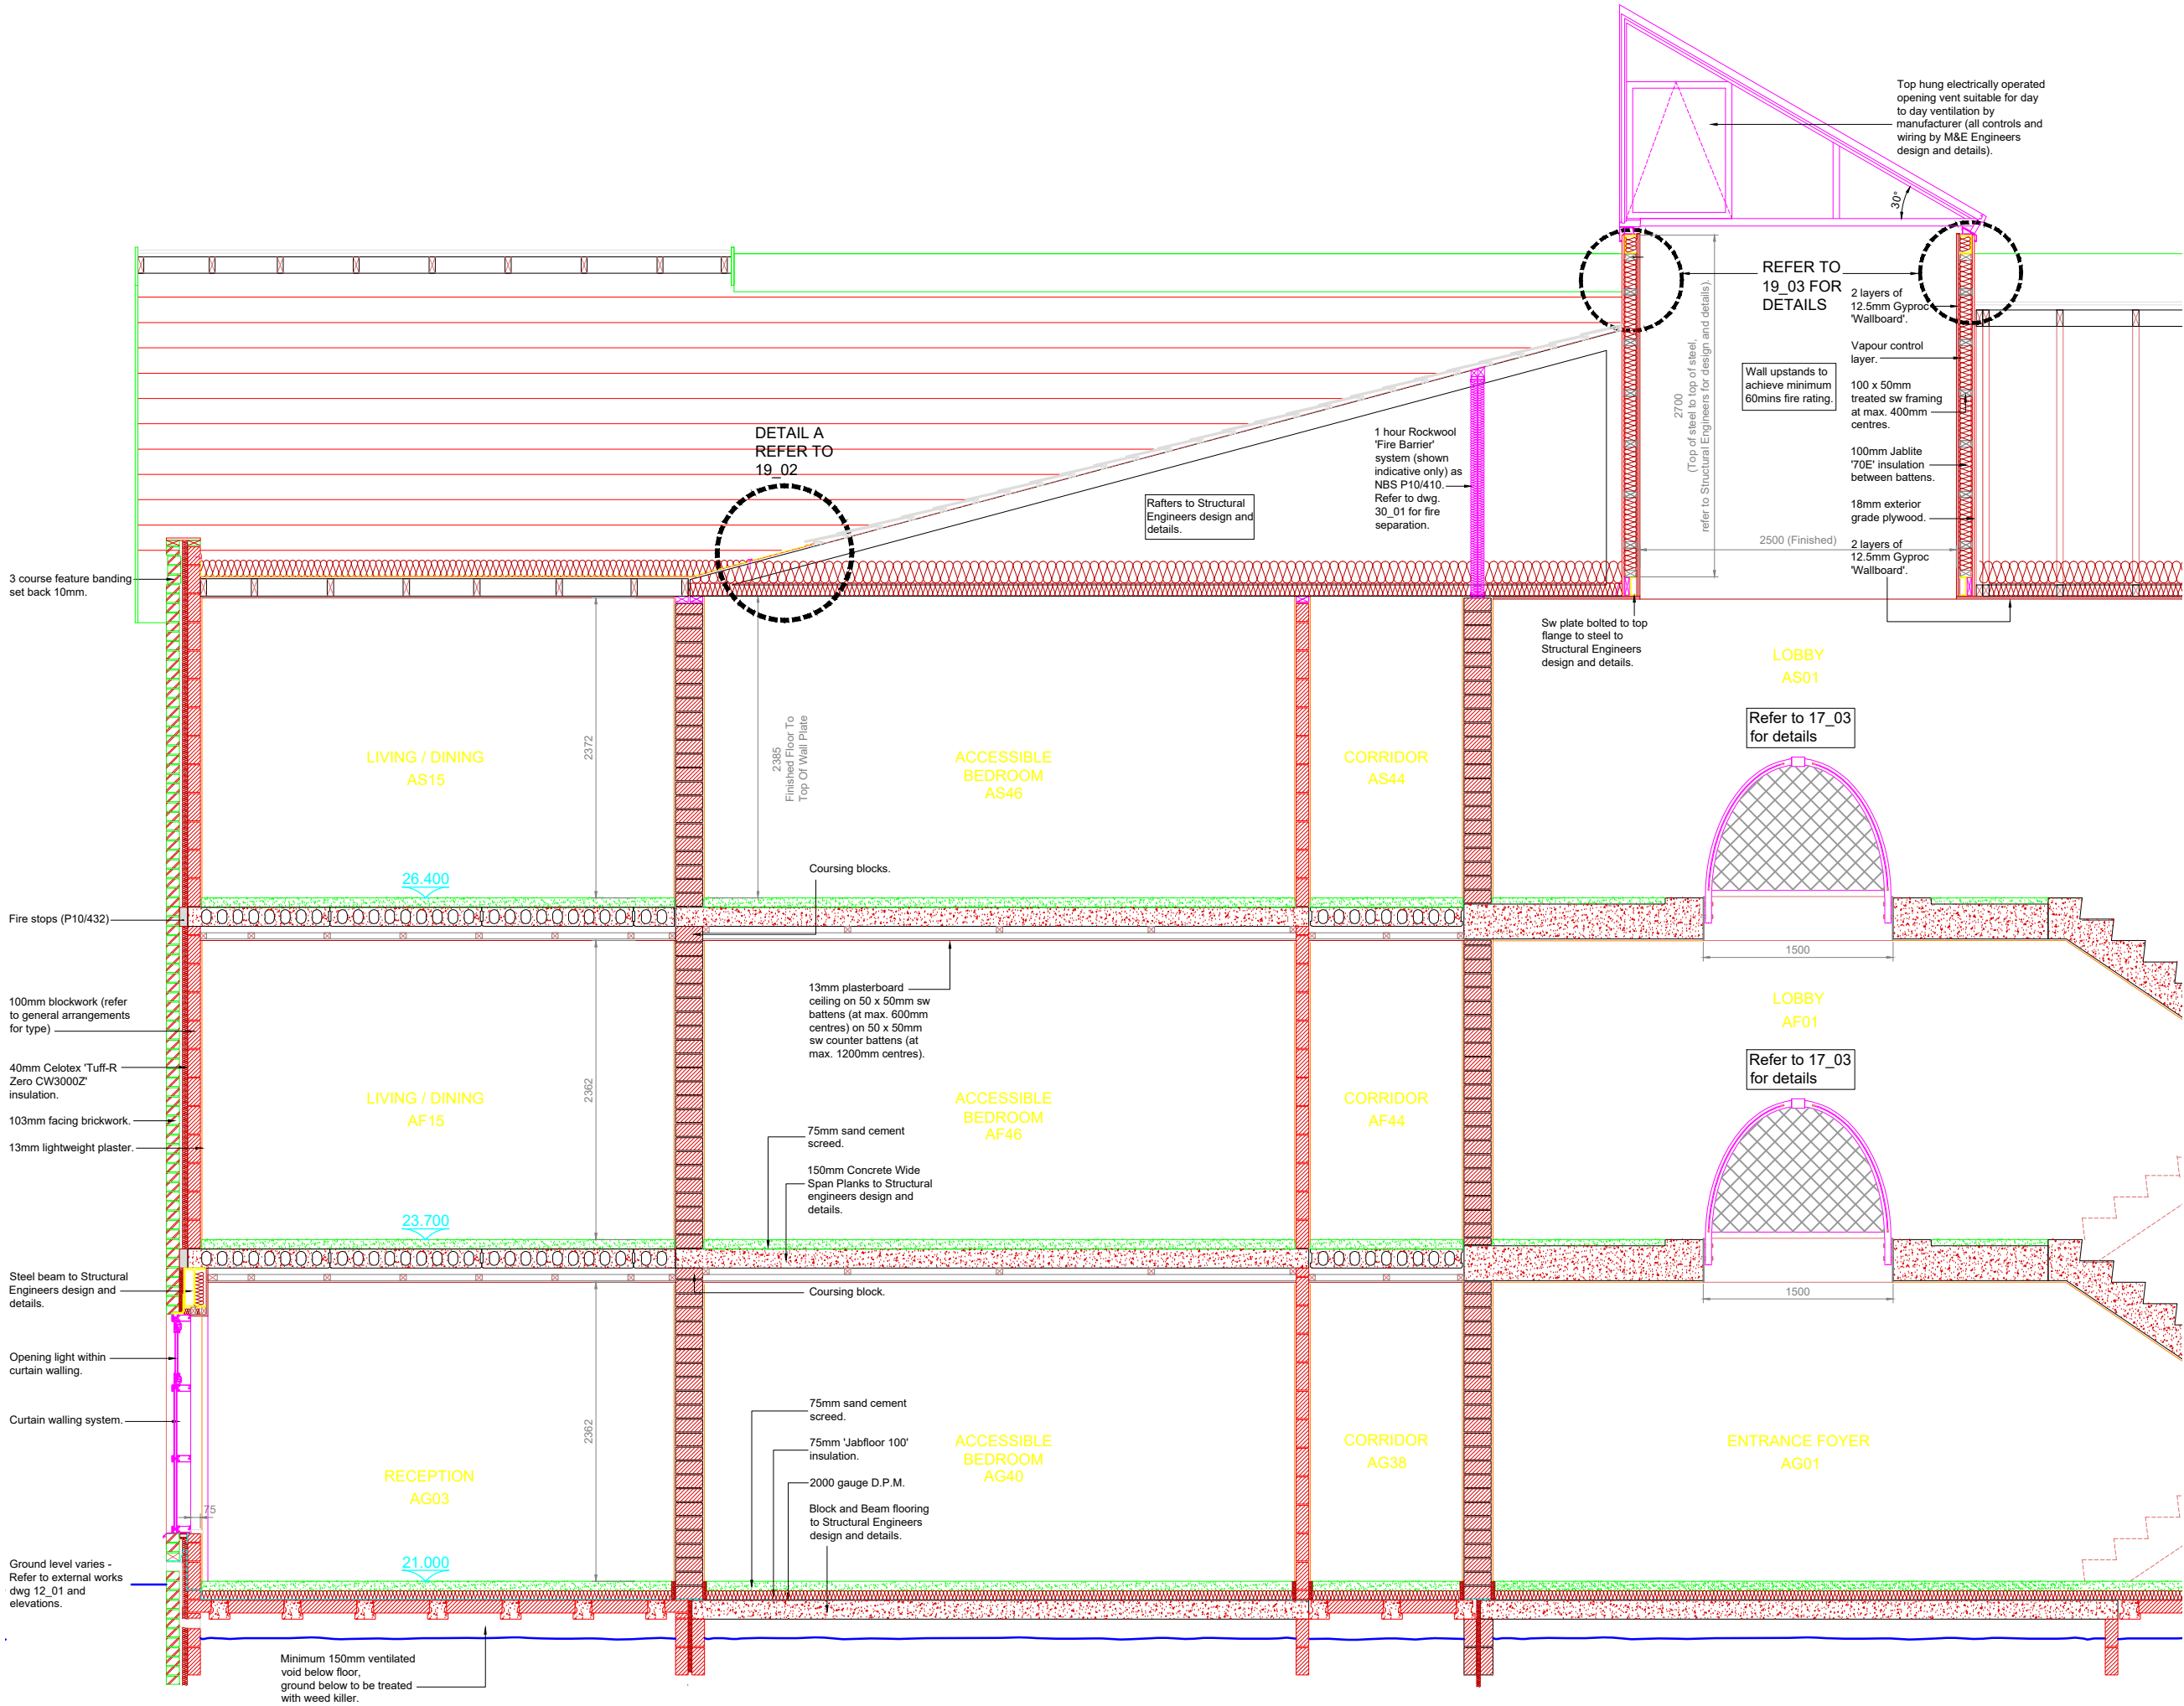

HNW Architects, 11 West Pallant, Chichester, West Sussex, PO19 1TB
Tel: 01243 533300 Fax: 01243 533311 E-mail: hnw@hnw.co.uk www.hnw.co.uk

Project
STUDENT RESIDENTIAL ACCOMMODATION, U.C.C. BISHOP OTTER CAMPUS

Drawing Title
SECTION A - A SHEET 1 of 2

Drawing Status
AS BUILT

Scale
1:25

Drawn By
BH

Date
OCT. 2004

Checked By
DJS

Date
NOV. 2004

Project No.
03021

Drawing No.
13_10

Revision
C

Harding Neill & Watson Limited - Registered No. 3589904